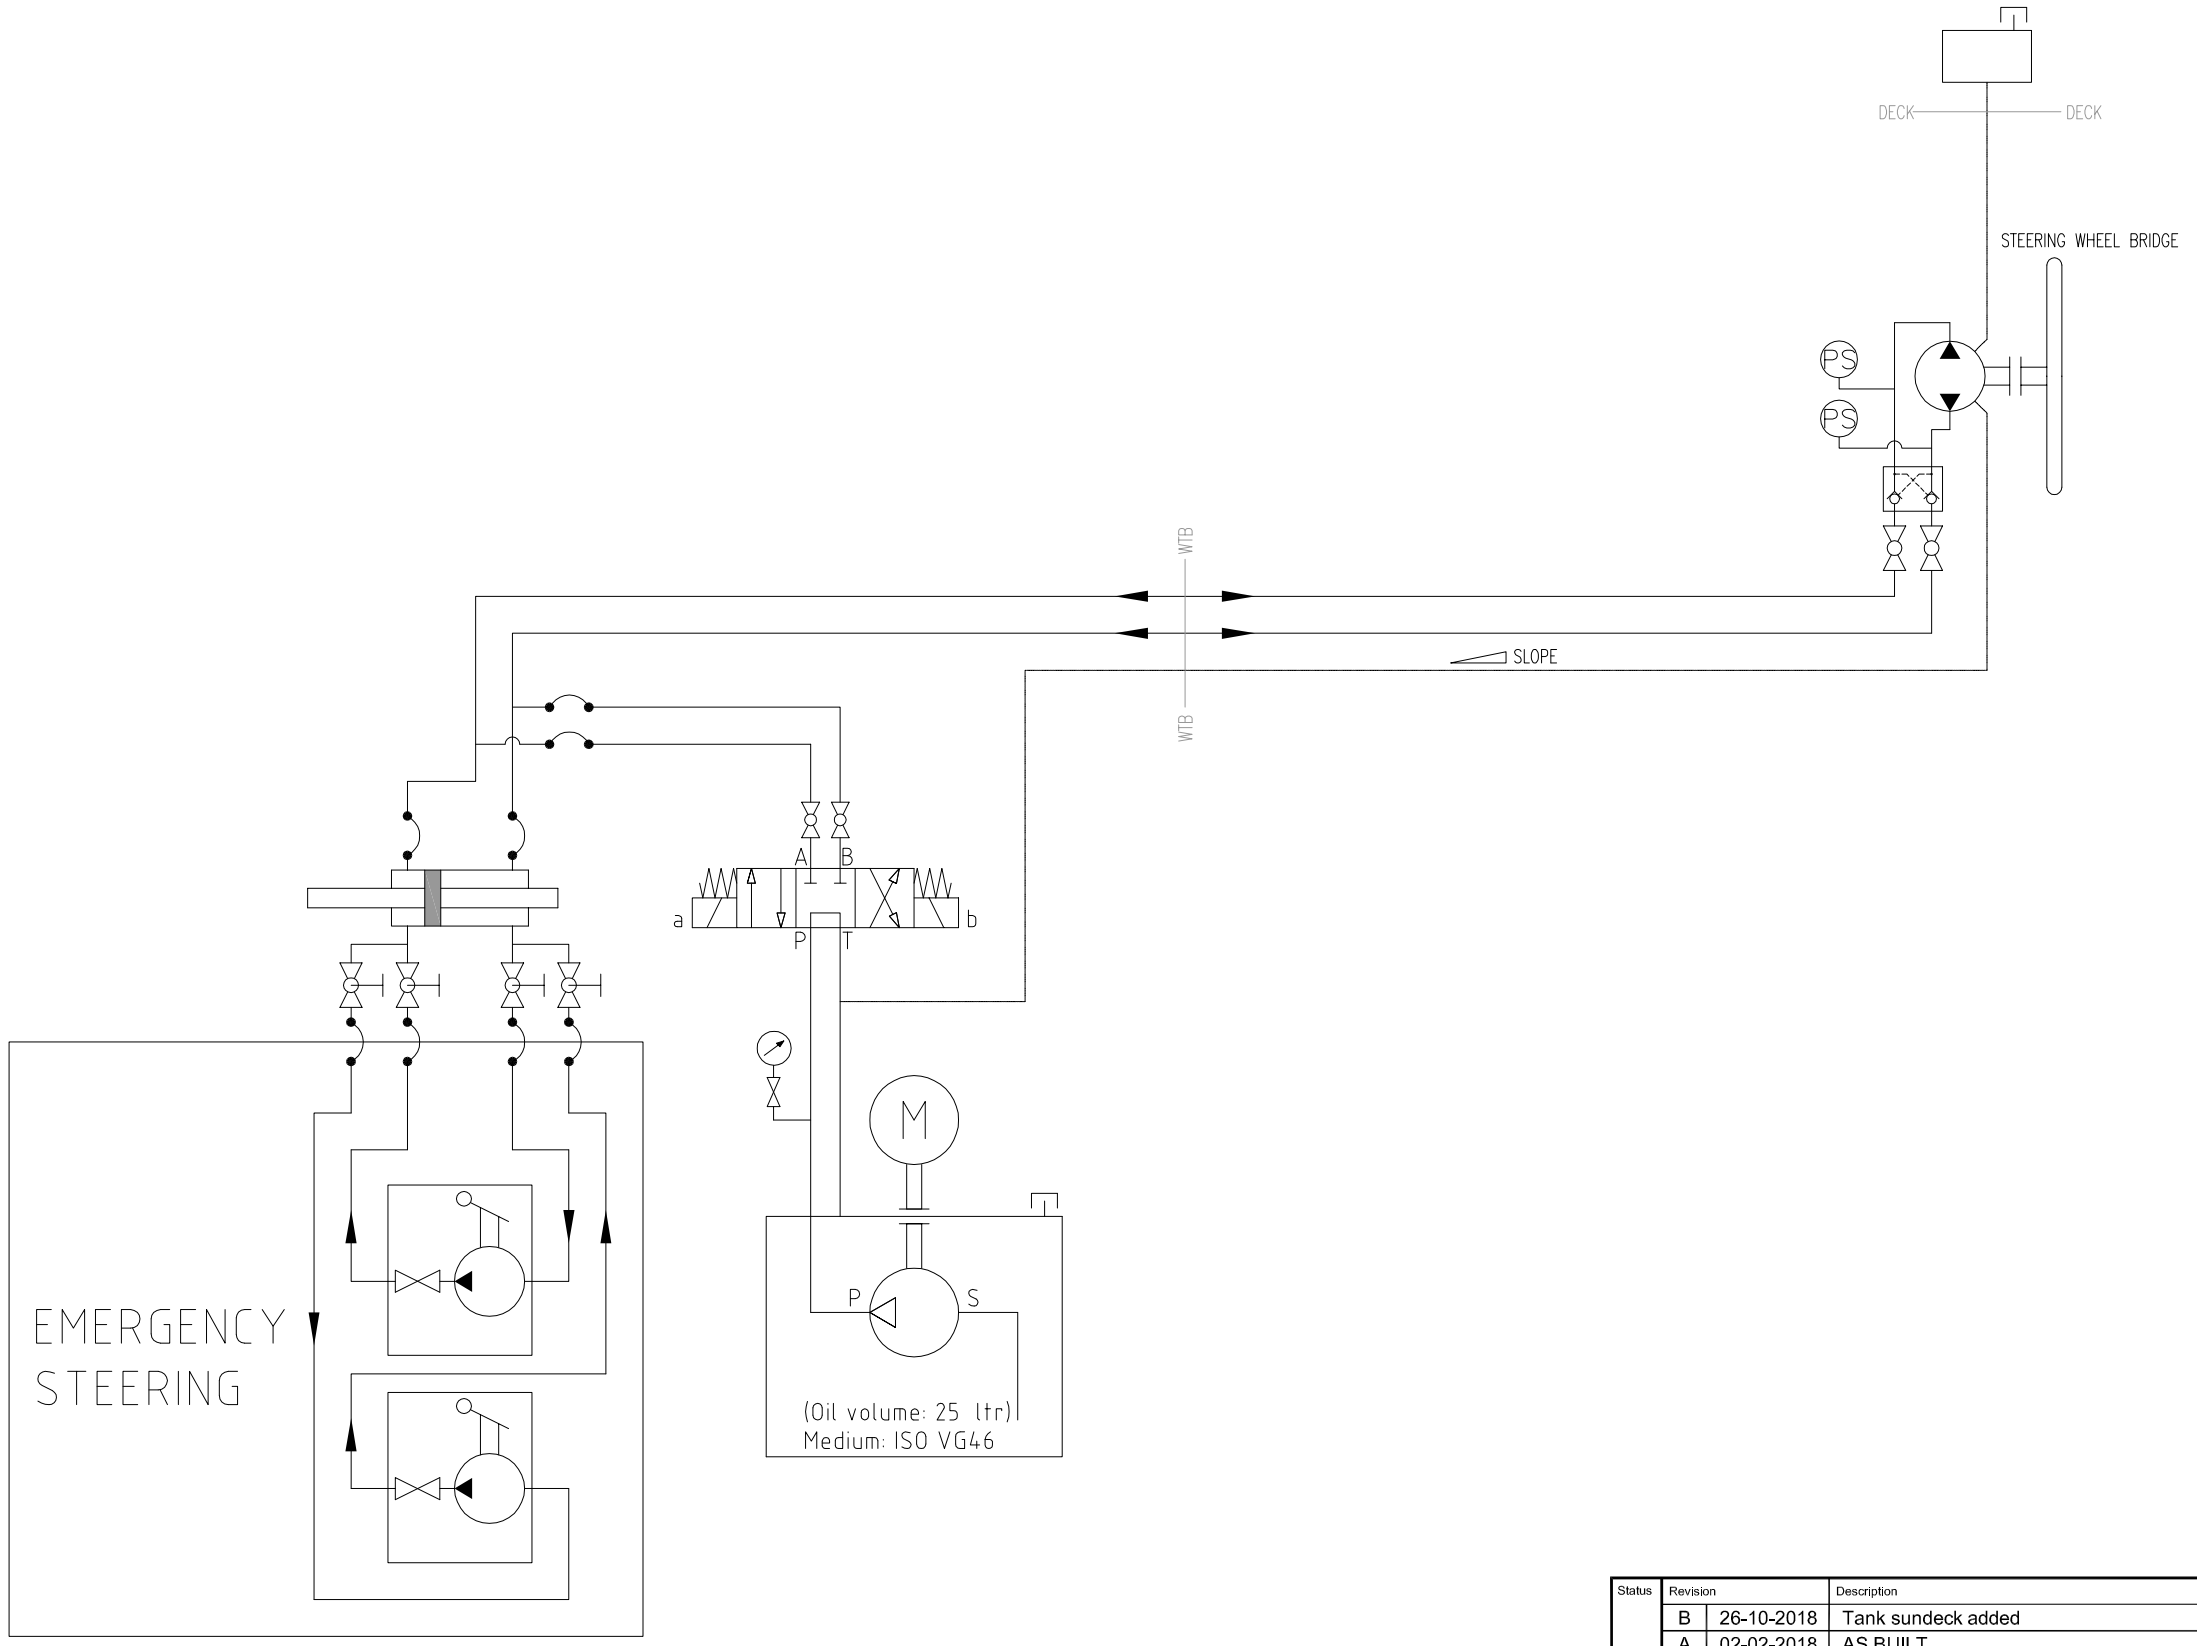

Status	Revision		Description	Drawn
RELEASED	B	26-10-2018	Tank sundeck added	OJvD
	A	02-02-2018	AS BUILT	OJvD

FEADSHIP
ROYAL DUTCH SHIPYARDS

KONINKLIJKE DE VRIES SCHEEPSBOUW

Strânwei 6
8754 HA Makkum
(0)515 445 700

Title: Hydraulic steering system schematic

Scale: N/A
Design No: 0000
refrence no: 586

Baseline:
Drawn: OJvD
Date: 01-02-2018
Size: A3

Projection

The information contained in this document is protected by copyright and property of Koninklijke De Vries Scheepsbouw Makkum. No part whatsoever may be copied, reproduced, modified or used in any manner without permission.

Company:	Department:	Block:	Deck:	Area:	Spec No:	Sequence No:	Sheet No:
40541	04	95	10	3350	0222	001	01

Record ID: 000000

Printed by otto.vandijk December 07 - 2018